
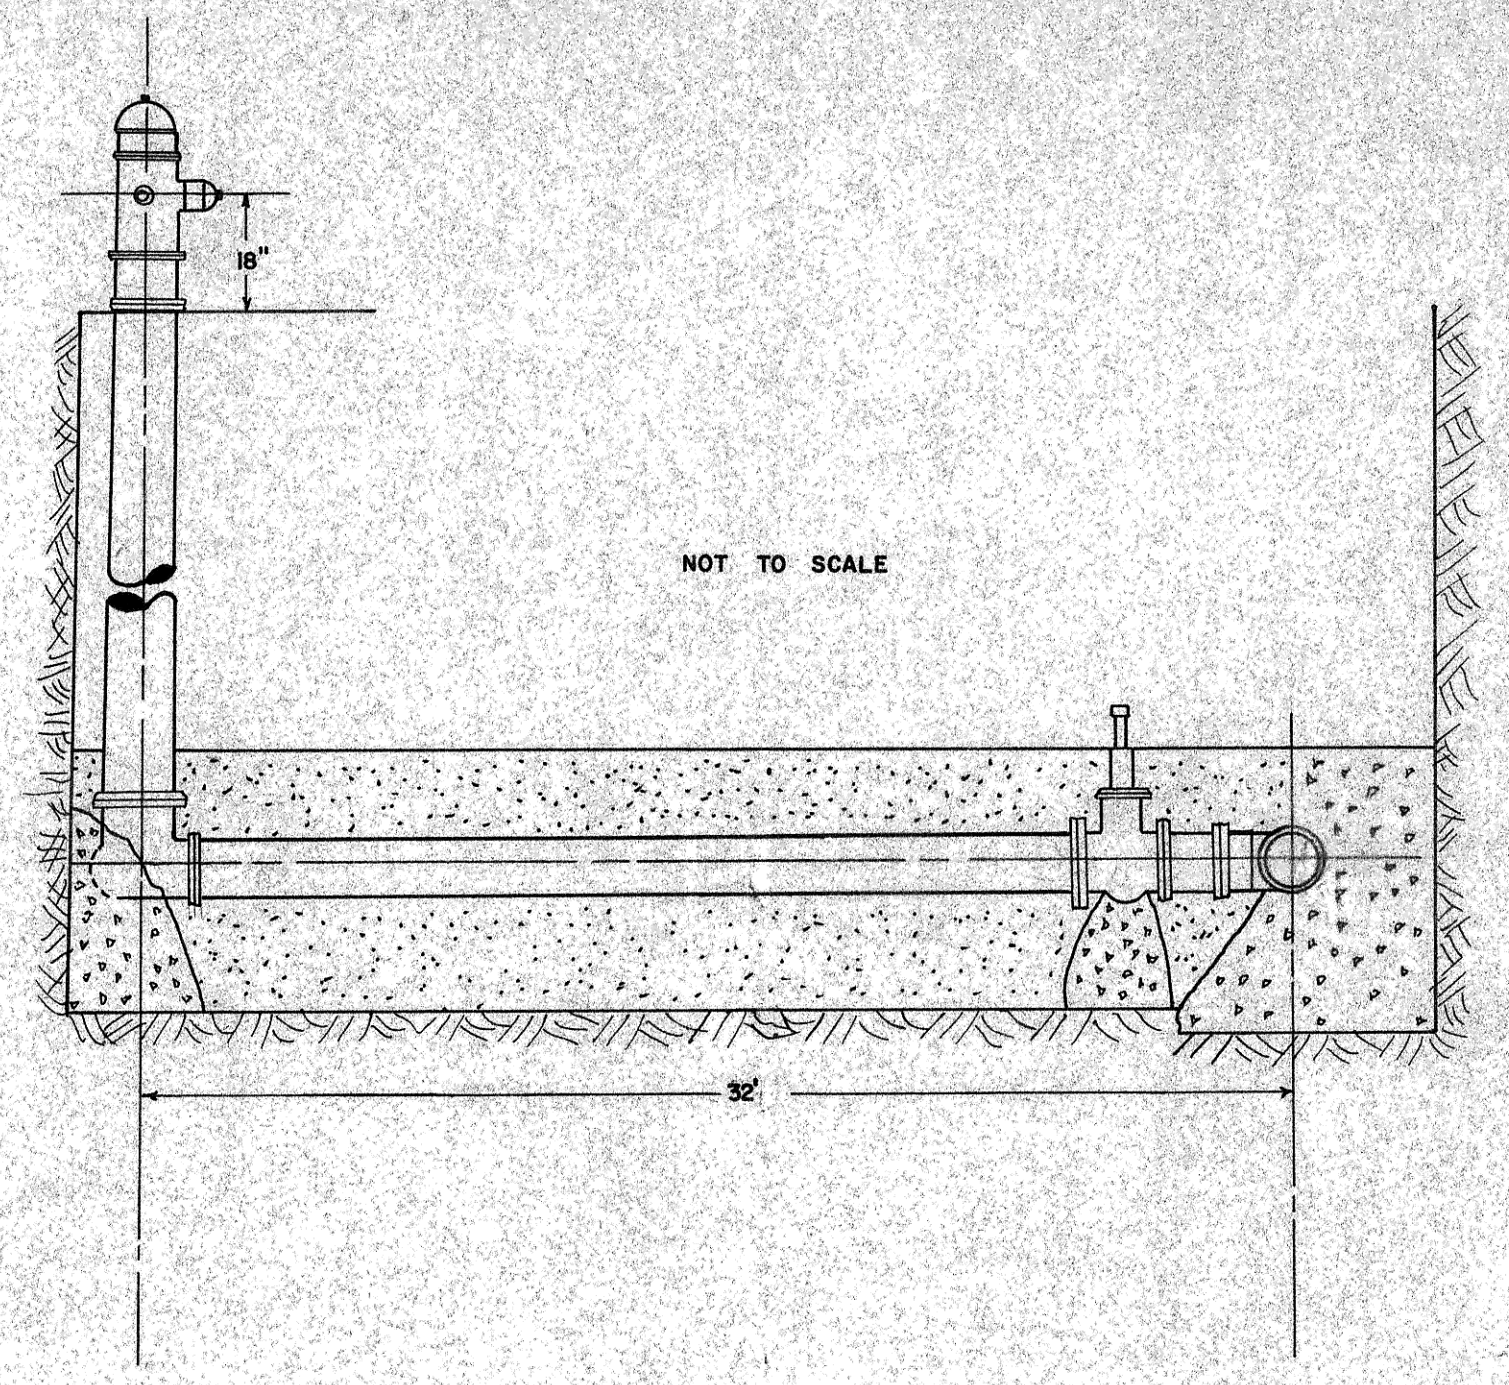


HORZ 1" = 30'
VERT 1" = 2'

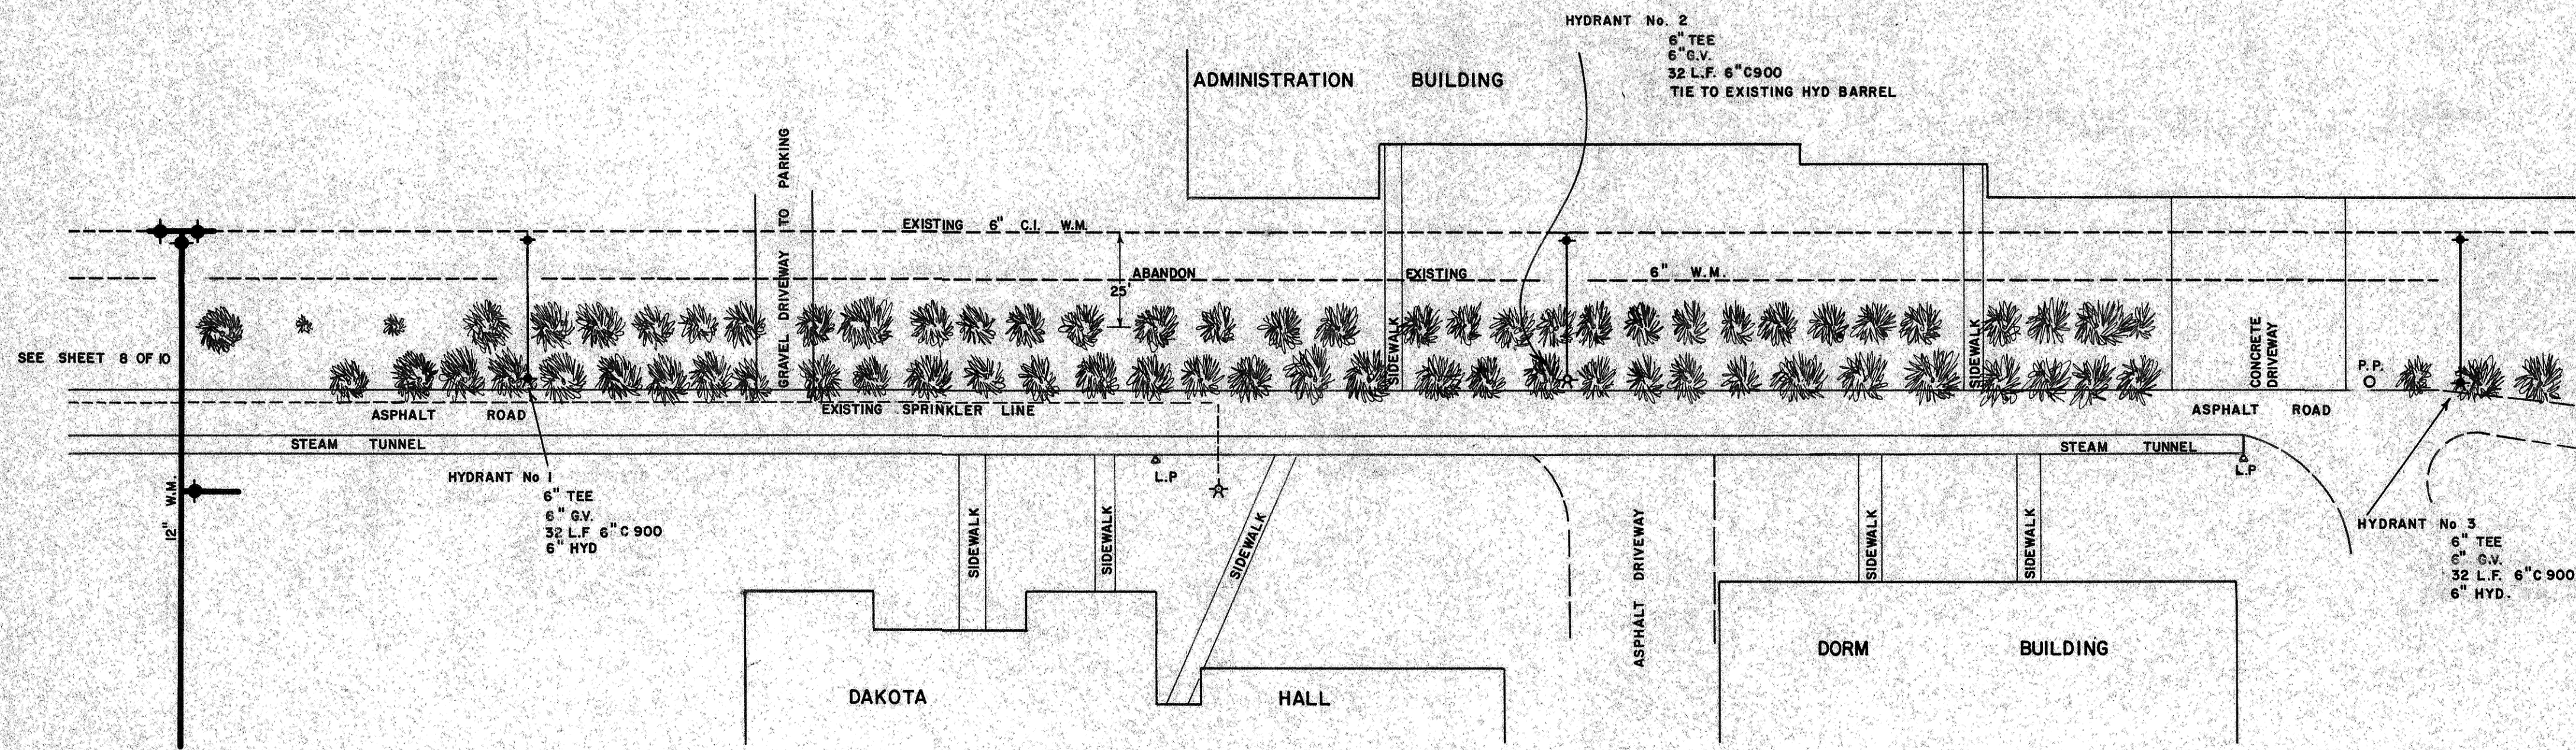


DATE	REV. BY	APPR. BY	DESCRIPTION
			CITY OF MANDAN, NORTH DAKOTA ENGINEERING DEPARTMENT
HYDRANT - Connections at S.I.S. grounds			
CITY ENGR. TOM LITTLE	DRAWN BY BILL BEMENT	SCALE: 1" = 30'	
APPROVED BY	CHECKED BY	DATE: MAY 1985	
PROJECT NO. 85-2	DISTRICT NO. 9	SHEET 9 OF 10	

DATE	BY

PLAN SURVEYED
NOTED BOOK
ALIGNMENT CHECKED
BY OF WAY CHECKED

DATE	BY

PROFILE SURVEYED
NOTED BOOK
STRUCTURE NOTATIONS CHECKED

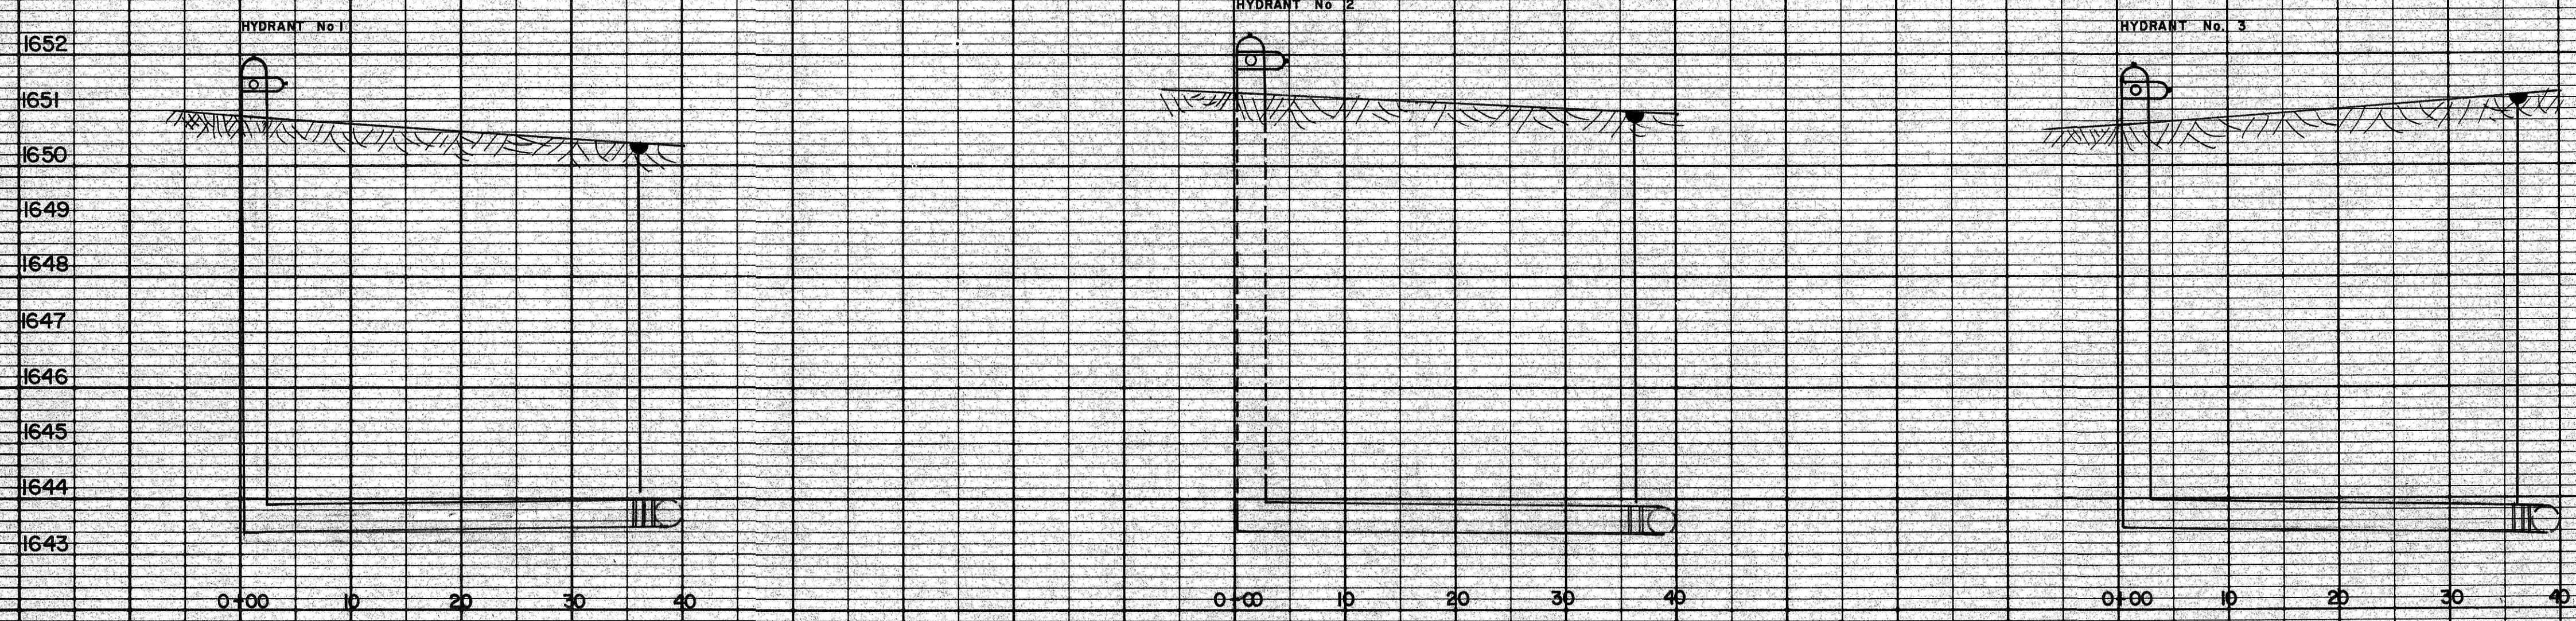

AS BUILT