



PLAN
 DRAWN BY: []
 CHECKED BY: []
 DATE: []

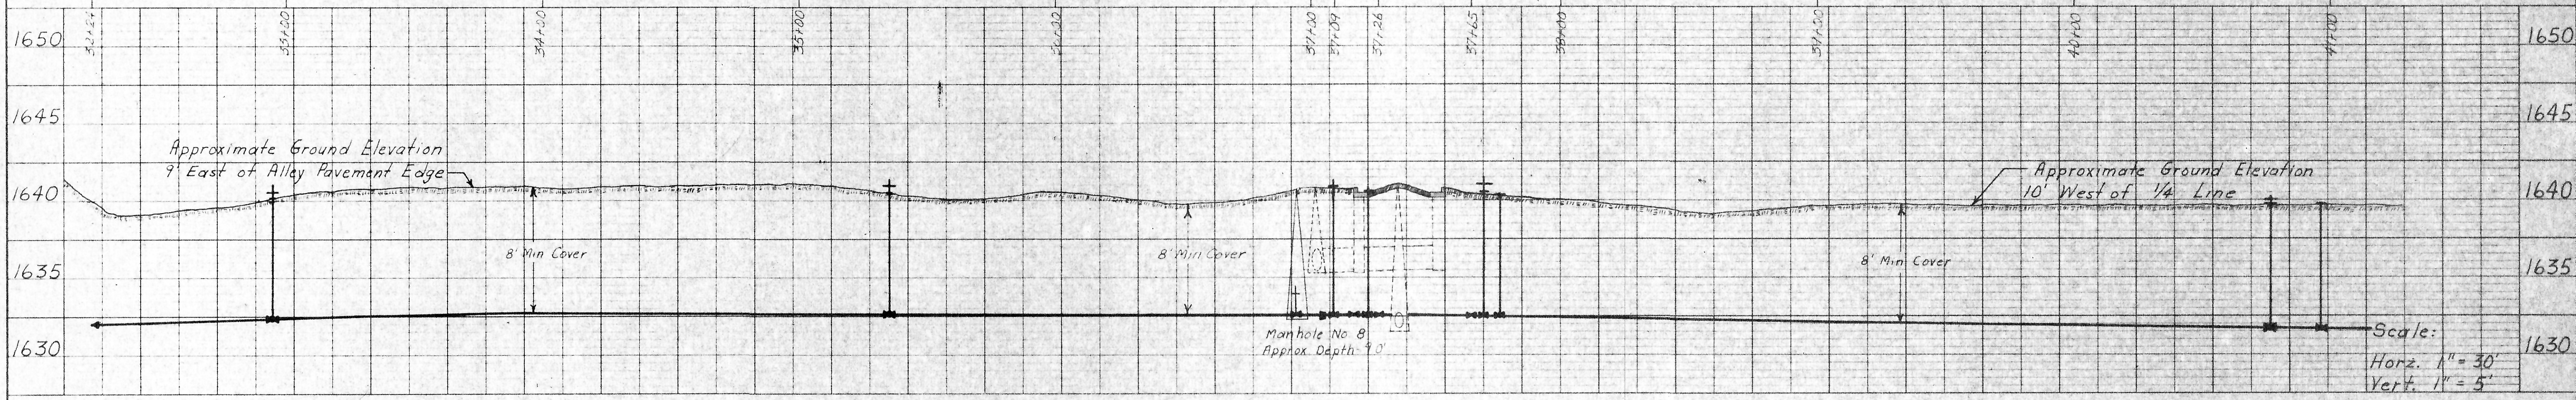

PROFILE
 DRAWN BY: []
 CHECKED BY: []
 DATE: []

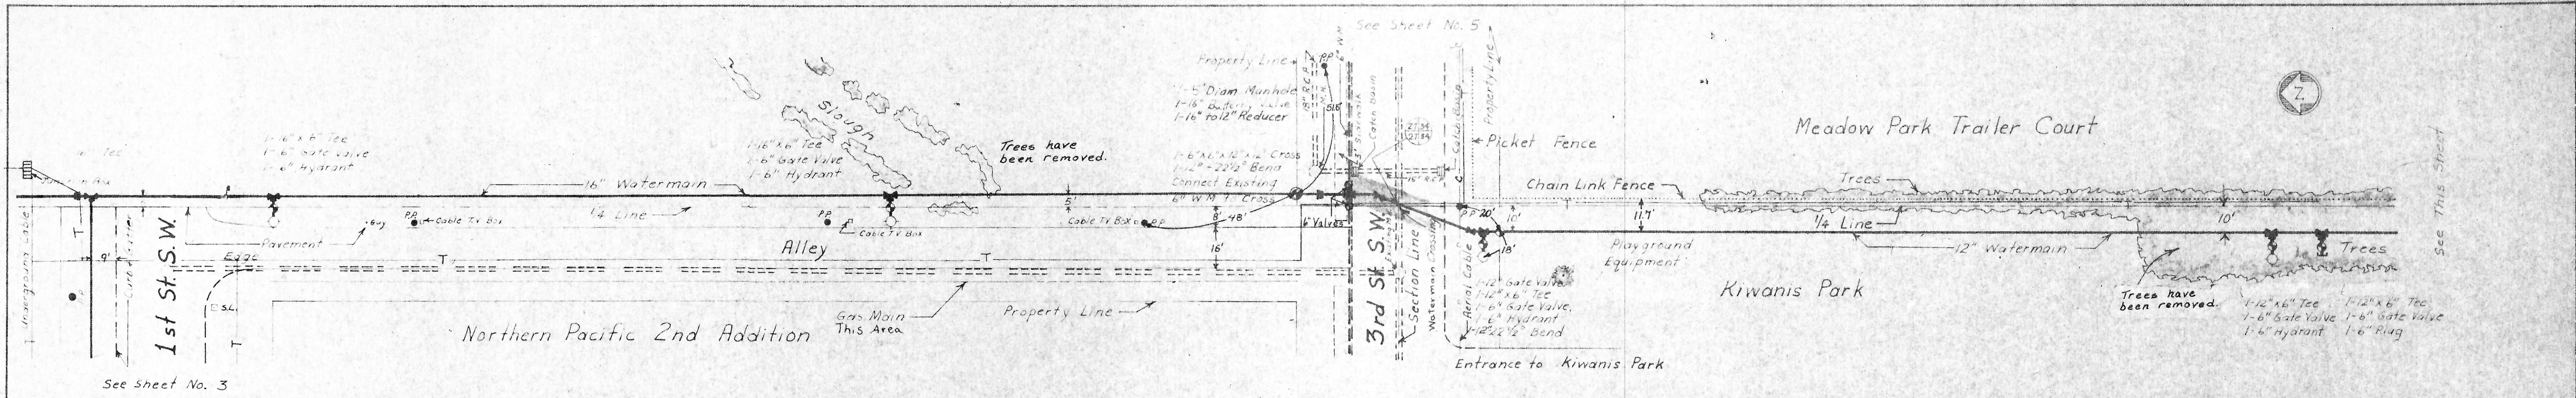