
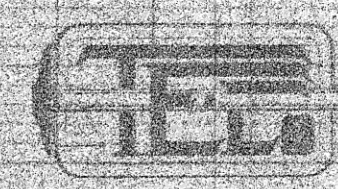
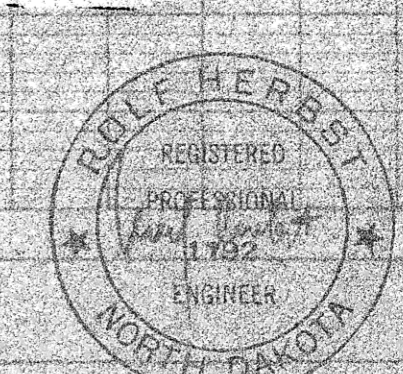
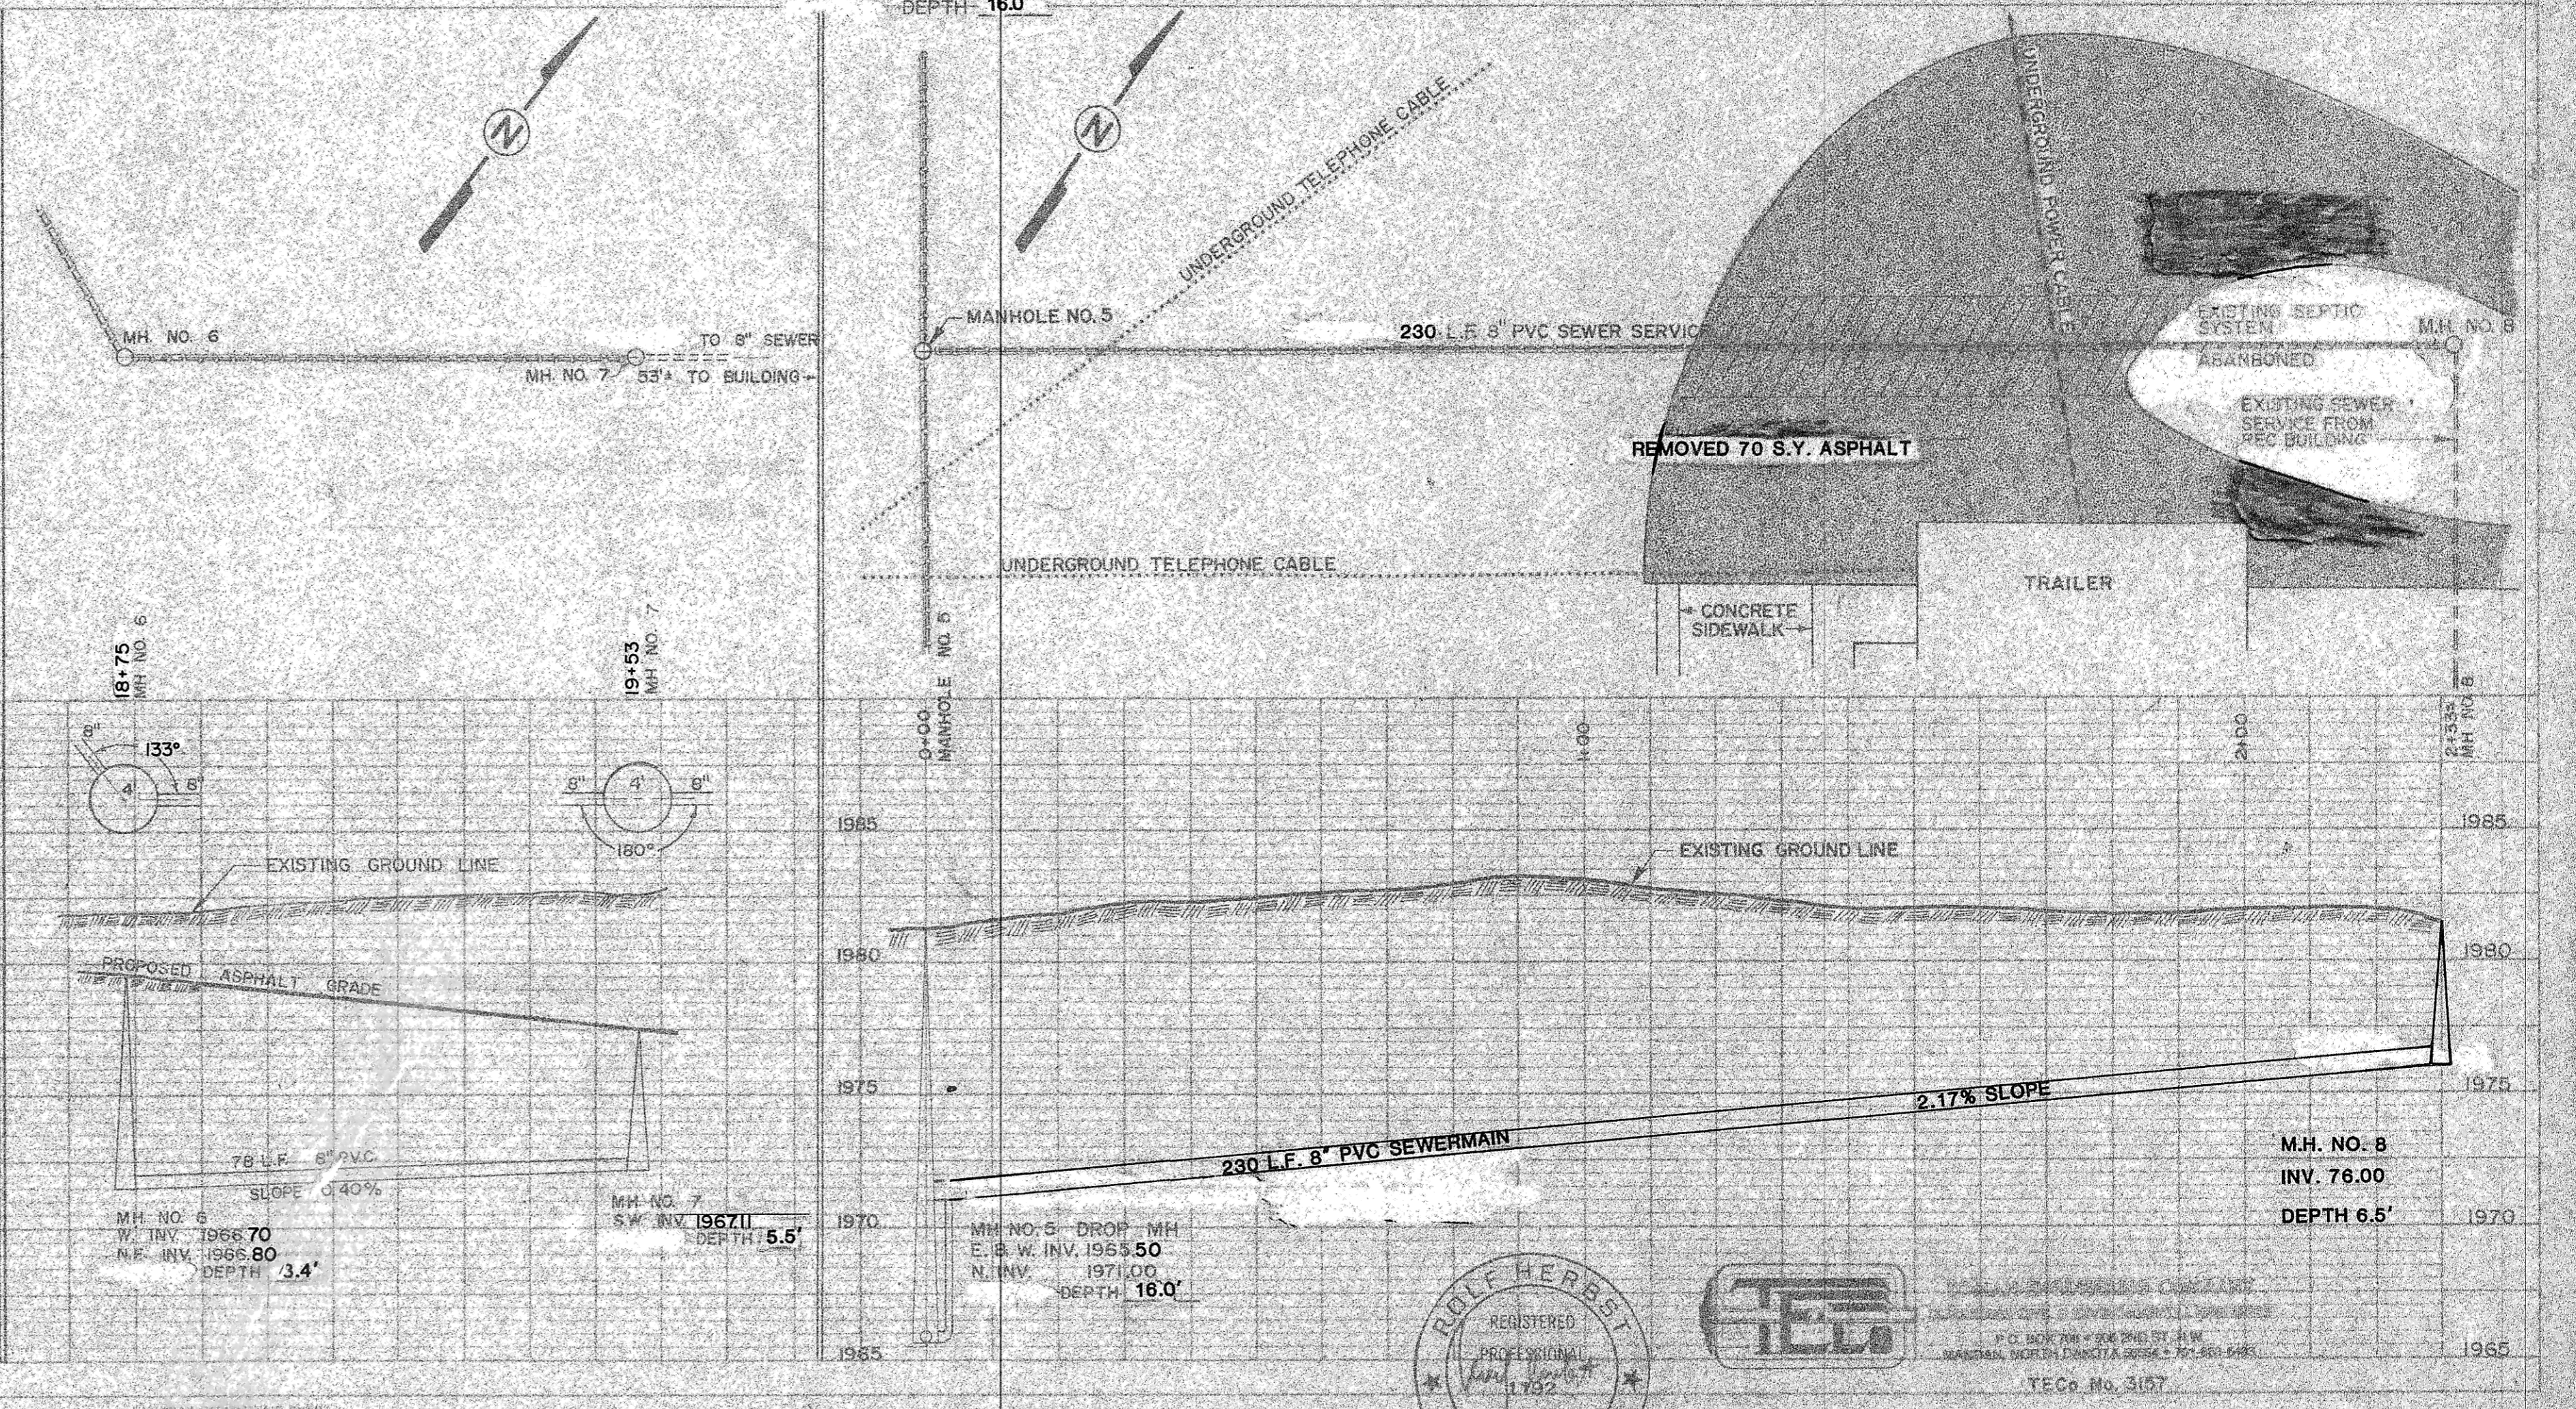
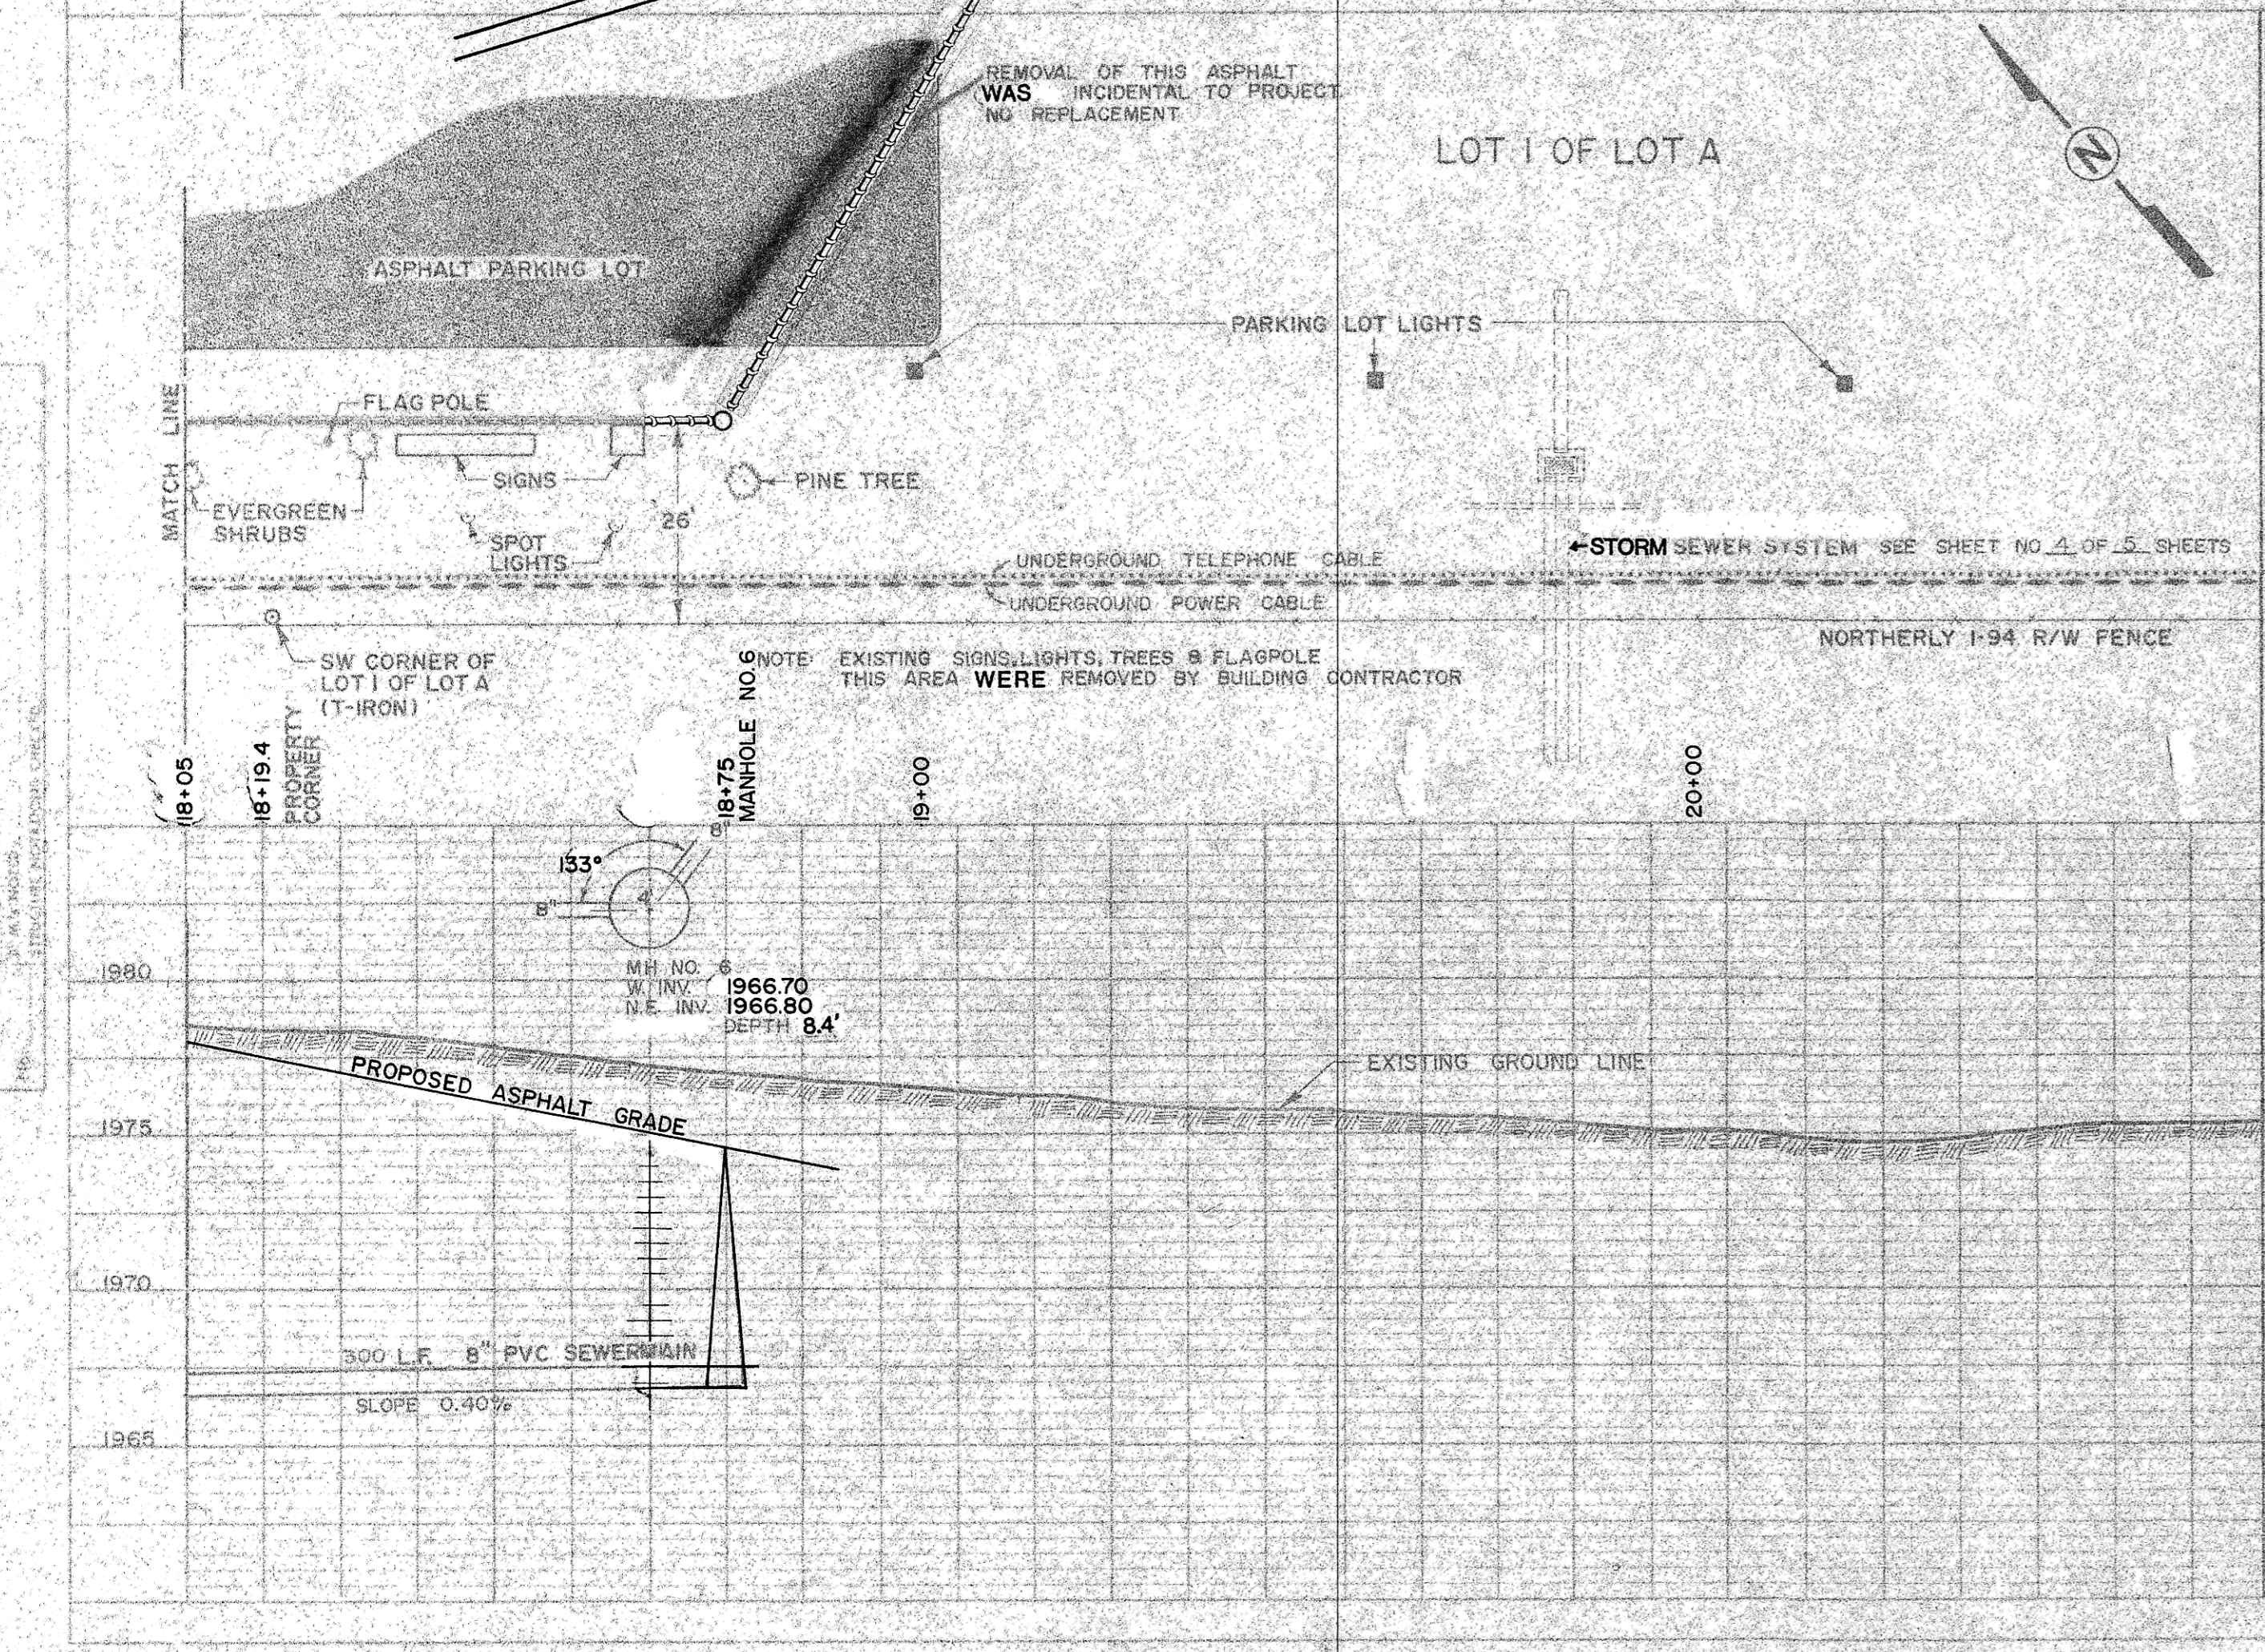
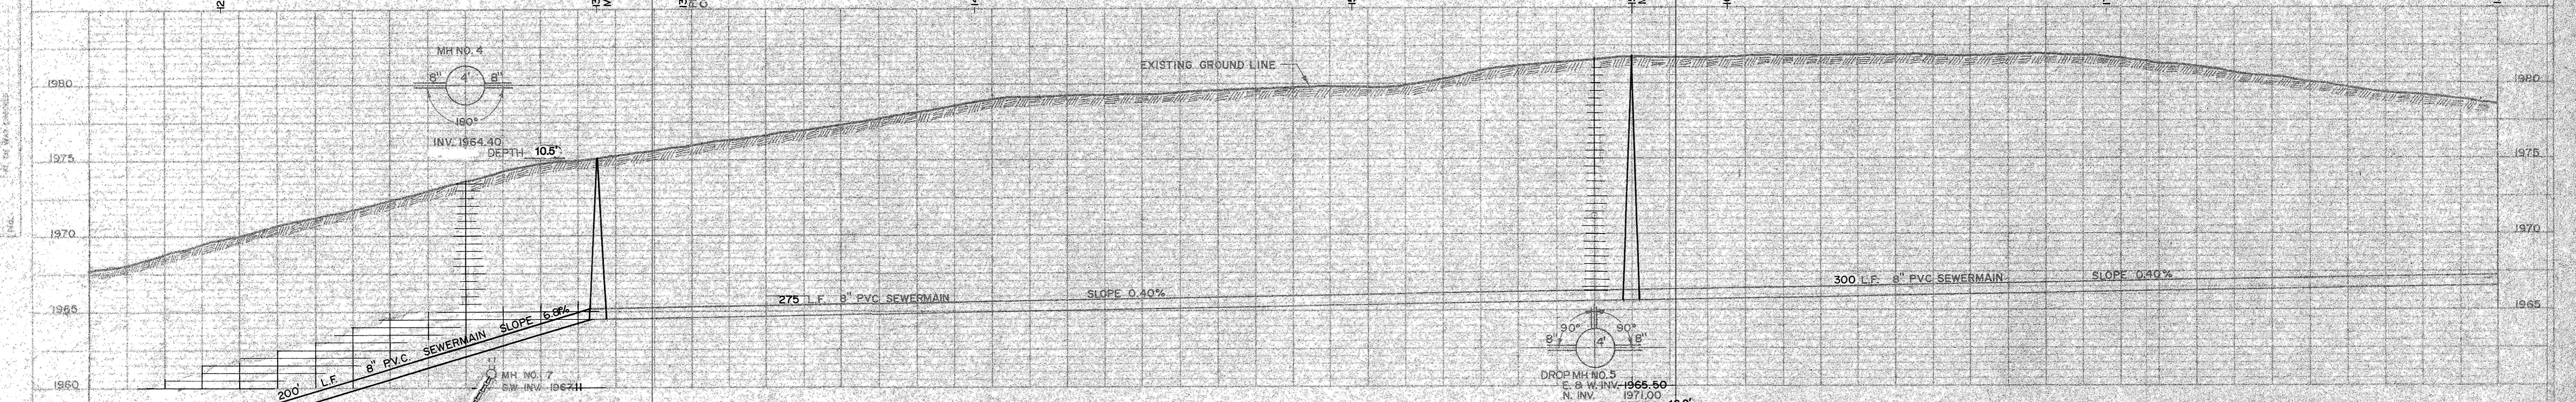
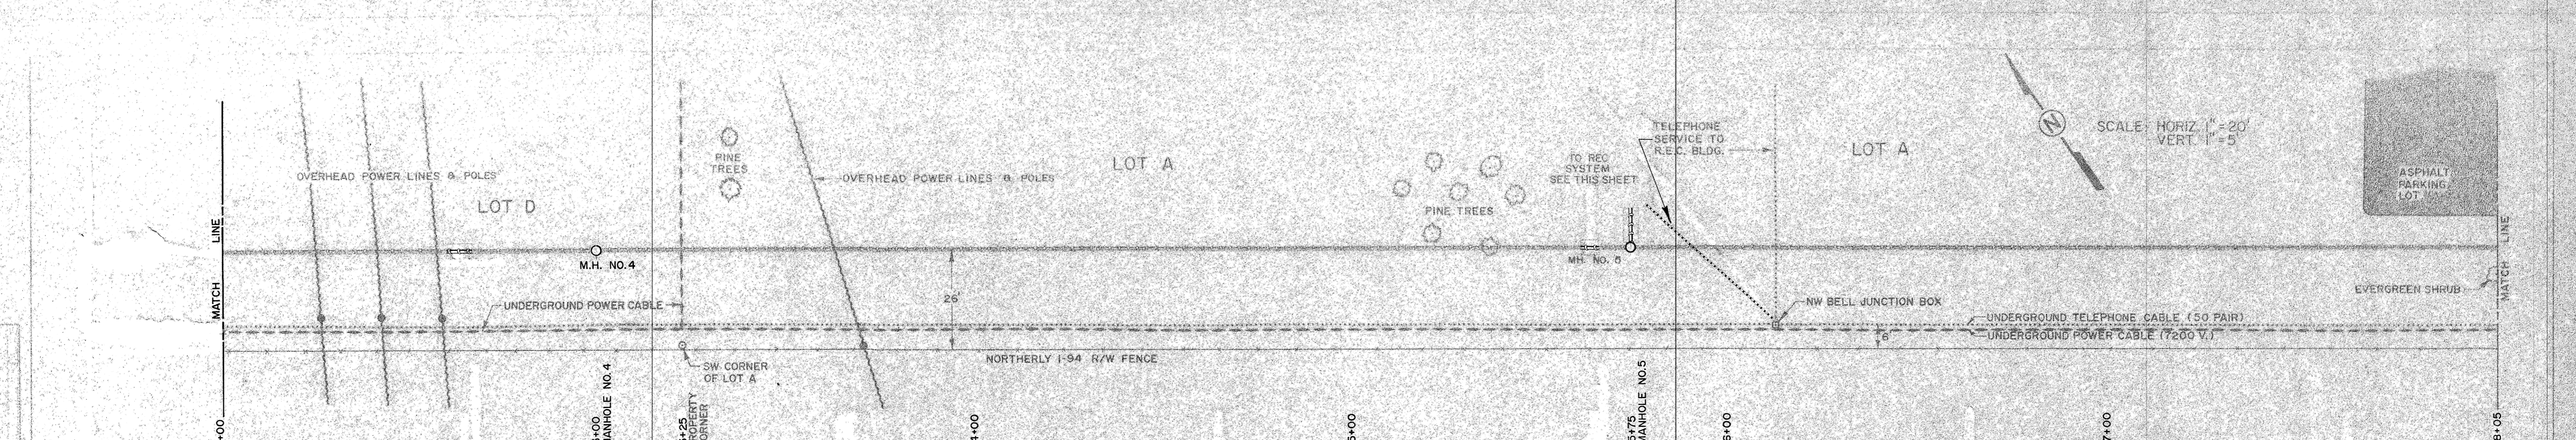


SCALE: HORIZ. 1" = 20'  
VERT. 1" = 5'

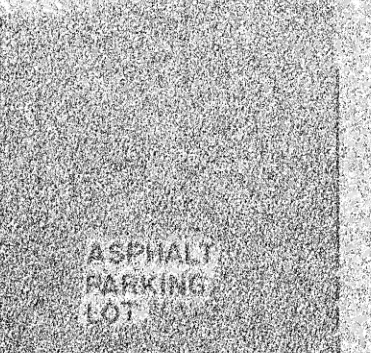

YE Co. No. 3157

REVISED 1982

SHEET NO. 3 OF 5 SHEETS  
ASBULT DRAWING